
ALASKA RAILROAD SEWARD PASSENGER DOCK REPAIR

SEWARD, ALASKA
NOVEMBER 2023
FEBRUARY, 2025

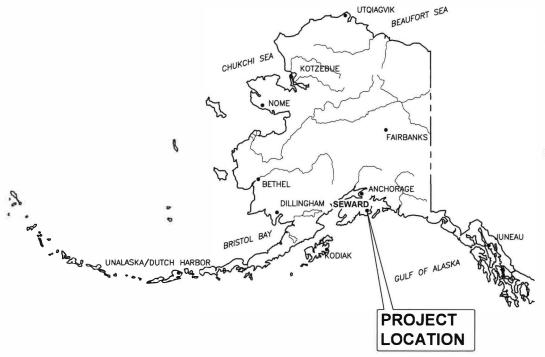

STATE OF ALASKA

DRAWING INDEX

SHEET TITLE	SHEET NO	
COVER SHEET & DRAWING INDEX	1	
GENERAL NOTES	2	
GENERAL LAYOUT PLAN (1 OF 2)		
GENERAL LAYOUT PLAN (2 OF 2)	4	
EXISTING SECTIONS	5	
TYPICAL REPAIR SECTIONS	6	
REPAIR DETAILS	7	




SEWARD VICINITY MAP

REVISED FOR DECKREASE ONLY - ARRC

2 28 2025



ISSUED FOR BID MARCH 5, 2025

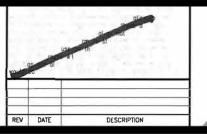

ALASKA RAILROAD SEWARD PASSENGER WEST DOCK REPAIR

COVER SHEET AND DRAWING INDEX

7				DRAWING NO:	SHET	HC
DESIGNED BY:	EAG	DATE:	3/5/25	1 4		
CHECKED BY:	DS	PROJECT NO:		j l	OF	(

GENERAL NOTES:

OWNER - ALASKA RAILROAD CORP. (ARRC)

ANY DISCREPANCIES FOUND AMONG THE DRAWINGS, SPECIFICATIONS, SITE CONDITIONS, AND THESE NOTES SHALL BE REPORTED TO THE OWNER/ENGINEER AT ONCE. ANY FURTHER WORK PERFORMED BY THE CONTRACTOR AFTER FINDING SUCH DISCREPANCIES SHALL BE DONE AT CONTRACTOR'S OWN RISK.

ORIGINAL STRUCTURAL DESIGN DRAWINGS ARE AVAILABLE UPON REQUEST. STRUCTURE WAS ORIGINALLY DESIGNED WITH AN AASHTO HS20-S16 LIVE LOAD, COOPER'S E50 RAILROAD LOAD, 50-KIP CRANE TIRE LOAD, AND 600 PSF UNIFORM LIVE LOAD. SEE DESIGN DRAWINGS FOR ADDITIONAL INFORMATION.

SCOPE OF WORK

VERTICAL SUPPORT H-PILE REPAIR AND REDISTRIBUTION OF LOAD TO SOUND STRUCTURAL COMPONENTS TO RAISE THE DOCK'S CAPACITY TO ACCOMMODATE AN HS-20 VEHICLE OR A REDUCED UNIFORM LIVE LOAD OF 100 PSF.

REPAIRS ARE INTENDED TO PROTECT AGAINST FURTHER SUPPORT PILE OVERSTRESSING AND TEMPORARILY EXTEND THE LIFE OF THE DOCK IN THE SHORT-TERM.

APPLICABLE CODE

ALL LOCAL CODES PLUS THE FOLLOWING SPECIFICATIONS, STANDARDS AND CODES ARE PART OF THESE GENERAL NOTES:

- 1. AASHTO LRFD BRIDGE DESIGN SPECIFICATIONS. 9TH ED
- 2. AISC STEEL DESIGN MANUAL, 15TH ED
- 3. ACI SPECIFICATIONS, 318-14 ED
- 4. UFC DESIGN OF PIERS AND WHARFS, 2017 ED
- 5. ASCE LOADS AND CRITERIA, 7-22 ED
- 6. ASCE WATERFRONT FACILITIES INSPECTION AND ASSESSMENT, NO. 130

IN THE EVENT THAT THERE IS A CONFLICT BETWEEN THE ABOVE REFERENCES AND THESE GENERAL NOTES THE FOLLOWING PRIORITY WILL BE FOLLOWED:

- 1. ALL PROJECT PERMIT REQUIREMENTS
- 2. THESE GENERAL NOTES AND PLANS
- LOCAL CODES
- 4. THE SPECIFICATIONS, STANDARDS AND CODES LISTED ABOVE IN ORDER OF PRECEDENCE

TIDAL_LEVELS

ELEVATION DATUM FOR THIS PROJECT IS 0.00 FT MEAN LOWER LOW WATER.

TIDAL DATUMS FOR NOAA STATION 9455090 (SEWARD, AK):

EXTREME HIGH WATER (EHW)	+15.70 FT	[01 JAN 1987]
HIGHEST ASTRONOMICAL TIDE (HAT)	+13.95 FT	[24 NOV 2003]
HIGH TIDE LINE (HTL)	+13.80 FT	[PER USACE]
MEAN HIGHER HIGH WATER (MHHW)	+10.63 FT	
MEAN HIGH WATER (MHW)	+ 9.71 FT	
MEAN SEAL LEVEL (MSL)	+ 5.56 FT	
MEAN TIDE LEVEL (MTL)	+ 5.55 FT	
MEAN LOW WATER (MLW)	+ 1.38 FT	
MEAN LOWER LOW WATER (MLLW)	0.00 FT	
LOWEST ASTRONOMICAL TIDE (LAT)	- 3.53 FT	[27 MAY 2021]
EXTREME LOW WATER (ELW)	- 5.01 FT	[14 DEC 2008]

PUBLICATION DATE: 29 SEPT 2011 EPOCH: 1983-2001 (PRESENT)

PERFORMANCE REQUIREMENTS

PILES IDENTIFIED FOR REPAIR WITHIN THE PLANS SHALL MEET THE FOLLOWING PERFORMANCE REQUIREMENTS WITHIN THE REPAIRED ZONE FOLLOWING REPAIRS:

- 1. DESIGN LIFE: 10 YEARS
- 2. ULTIMATE AXIAL STRENGTH: 420 K
- 3. ULTIMATE FLEXURAL STRENGTH: 290 K-FT

NOTE: THE PERFORMANCE CAPACITY REQUIREMENTS PROVIDED ARE FACTORED IN ACCORDANCE WITH AASHTO LRFD BRIDGE DESIGN SPECIFICATIONS, 9TH ED.

MATERIALS

ALL STEEL BOLTS COMPONENTS SHALL BE ASTM A325 GALVANIZED INCLUDING WASHERS UNLESS NOTED OTHERWISE.

ALL STRUCTURAL STEEL SHAPES SHALL BE ASTM A572 GR 50 OR ASTM A992 GR 50.

ALL REINFORCED CONCRETE SECTIONS SHALL SATISFY THE FOLLOWING REQUIREMENTS:

- f'c @ 28 DAYS = 4 KSI
- W/C = 0.42 MAX
- AIR CONTENT = 4.5-7.5%
- SLUMP = 4-8"
- f, REINFORCING = 60 KSI
- PAN DECK (AS REQ.) = 18 GA GALV

ALL CONCRETE SHALL BE COLD WEATHER CONCRETE CONFORMING TO ACI 306. PORTLAND CEMENT SHALL CONFORM TO ASTM C150 TYPE III HIGH EARLY WITH TRI-CALCIUM ALUMINATE CONTENT BELOW 8%. AGGREGATE SHALL CONFORM TO ASTM C-33 WITH A MAXIMUM SIZE OF 3/4-INCH. CONCRETE SHALL HAVE A MINIMUM 28 DAY COMPRESIVE STRENGTH (F'C) OF 4,000 PSI. ENTRAINED AIR SHALL BE 4.5% TO 7.5%. WATER-CEMENTITIOUS MATERIALS RATIO 0.42 MAXIMUM. 4-INCH MAXIMUM SLUMP PRIOR TO ADDITION OF WATER REDUCER.

CONSTRUCTION JOINTS AND SAW-CUT EXPANSION JOINTS SHALL BE INSTALLED WHERE REQUIRED IN DRAWINGS AT INTERVALS NOT TO EXCEED 12' BOTH DIRECTIONS WITH A TRANSVERSE JOINT PLACED OVER EACH BENT LOCATION. FORMS SHALL BE FREE OF SNOW AND ICE PRIOR TO PLACEMENT OF CONCRETE. WHERE REQUIRED, CONSTRUCTION JOINTS SHALL BE APPROVED BY ENGINEER. FOR CONSTRUCTION JOINTS NOT COINCIDENT WITH CONTROL JOINT LOCATIONS, EUCLID COMPANY EUCO #452 EPOXY BONDING AGENT, OR APPROVED EQUAL, SHALL BE APPLIED TO FINISHED CONCRETE PER MANUFACTURER'S SPECIFICATIONS.

ADMIXTURES SHALL MEET ASTM C-494, TYPE F OR TYPE E FOR COLD WEATHER CONCRETE. ADMIXTURES CONTAINING CHLORIDE SHALL NOT BE USED.

CONTRACTOR SHALL PROVIDE QUALITY CONTROL DURING ALL CONCRETE OPERATIONS. QUALITY CONTROL WILL INCLUDE MONITORING OF BACTHING, MONITORING OF TRANSPORTATION, MONITORING OF PLACEMENT, MONITORING OF CONCRETE CURE, COLLECTION OF TEST CYLINDERS, BREAKING OF TEST CYLINDERS, SLUMP TEST, AIR ENTRAINMENT TESTS AND ALL OTHER QUALITY ASPECTS RELATED TO FINAL CONCRETE PRODUCT. CONTRACTOR SHALL SUBMIT CERTIFICATE OF CONFORMANCE WITH EACH TRUCK LOAD OF CONCRETE PRIOR TO PLACEMENT. OWNER MAY PROVIDE ADDITIONAL PERSONNEL FOR CONCRETE QUALITY ASSURANCE AT OWNER'S DISCRETION.

CONTRACTOR SHALL NOTIFY THE ENGINEER 7 DAYS IN ADVANCE OF ANY POUR. A MINIMUM OF 8 TEST CYLINDERS SHALL BE TAKEN AND TESTED FROM EACH 100 CUBIC YARDS, OF RACTION THEREOF, OF CONCRETE PLACED EACH DAY. TWO CYLINDERS WILL BE BROKEN AT 3-DAYS, TWO AT 7 DAYS, TWO AT 28 AND TWO CYLINDERS WILL BE HELD IN RESERVE. ALL TESTING SHALL BE PERFORMED BY A THIRD-PARTY Q.C. IN ACCORDANCE WITH ACI 301. MATERIALS AND INSTALLED WORK MAY REQUIRE TESTING AND RE-TESTING AS DIRECTED BY THE ENGINEER. TRAFFIC WILL NOT BE ALLOWED ON NEW CONCRETE UNTIL CYLINDER BREAKS STRENGTHS ACHIEVE 4000 PSI.

ALL SURFACES SHALL BE WATER CURED AND KEPT THOROUGHLY WET, USING POTABLE WATER, FOR A MINIMUM OF (6) DAYS UNLESS OTHERWISE APPROVED BY ENGINEER. ACI 306 SHALL BE FOLLOWED THROUGHOUT THE PROJECT. THE CONCRETE ROADWAY SHALL RECEIVE TRANSVERSE BROOM FINISH. FINISHED SURFACE TOLERANCES SHALL BE TRUE PLANES WITHIN 1/4-INCH IN 10 FT IN ANY DIRECTION.

ALL REINFORCING SHALL BE NEW BILLET STOCK ASTM A-615, GRADE 60 STEEL UNLESS NOTED OTHERWISE. BARS SHALL BE SUPPORTED ON APPROVED CHAIRS AND SHALL BE DETAILED, BENT, AND PLACED IN ACCORDANCE WITH LATEST ACI 318. BARS SHALL BE CLEAN AND FREE FROM CUTTING OIL OR OTHER DELETERIOUS MATERIAL. LAP SPLICE SHALL BE 2'-6" UNLESS OTHERWISE NOTED.

PROJECT_PERMIT_REQUIREMENTS

CONTRACTOR SHALL COMPLY WITH THE REQUIREMENTS OF ALL PROJECT PERMITS. CONTRACTOR SHALL COMPLY WITH ALL FEDERAL, STATE, AND LOCAL LAWS.

THIS PROJECT HAS SOME REQUIREMENTS TO FULFILL STATE AND FEDERAL PERMIT STIPULATIONS. THE CONTRACTOR WILL BE RESPONSIBLE FOR KNOWING, UNDERSTANDING, AND IMPLEMENTING ALL OF THE THESE REQUIREMENTS DURING ALL STAGES OF PROJECT CONSTRUCTION. THE CONTRACTOR MUST UNDERSTAND THAT SOME OF THESE REQUIREMENTS WILL AND TIME AND/OR COST TO THE EXECUTION OF VARIOUS TASKS ASSOCIATED WITH PROJECT COMPLETION.

ACCESS AND STAGING

CONTRACTOR SHALL NOT BLOCK ARRC PARKING AREAS OR EGRESS AROUND TERMINAL BUILDING, UNLESS APPROVED BY OWNER.

CONTRACTOR MUST COORDINATE WORK WITH ARRC OPERATIONS ON AND NEAR THE DOCK. SEWARD PORT MANAGER: (907) 265-2696

SUBMITTAL REQUIREMENTS

CERTIFICATIONS, MANUFACTURER'S DATA, AND OTHER INFORMATION FOR ALL MATERIALS, INCLUDING THOSE NOT SPECIFICALLY NOTED IN THE GENERAL NOTES OR SHOWN ON INDIVIDUAL DRAWINGS, SHALL BE SUBMITTED TO THE ENGINEER FOR WRITTEN APPROVAL. ALL METHODS AND MATERIALS SHALL CONFORM TO THE CONTRACT DOCUMENTS, GENERAL NOTES, THE PLANS, GOOD WORKMANSHIP, GENERALLY ACCEPTED INDUSTRY STANDARDS, AND MANUFACTURER'S RECOMMENDATIONS. ALL CAPACITY CALCULATIONS SHALL CONFORM TO AASHTO LEFD SPECIFICATIONS, 9TH ED. A REVIEWED COPY OF EACH SUBMITTAL WILL BE RETURNED AND MARKED AS REQUIRED FOR ACCEPTANCE AND NON-ACCEPTANCE.

ELECTRONIC SUBMITTALS ARE PREFERRED. FOR HARD COPY SUBMITTALS, A MINIMUM OF THREE (3) SETS SHALL BE PROVIDED WITH EACH SUBMITTAL. REVIEWED COPIES WILL BE RETURNED TO THE CONTRACTOR AND MARKED AS REQUIRED FOR ACCEPTANCE OR NON-ACCEPTANCE. THE ENGINEER'S REVIEW OF SUBMITTALS WILL BE FOR GENERAL CONFORMANCE ONLY, AND IT SHALL REMAIN THE RESPONSIBILITY OF THE CONTRACTOR TO PERFORM ALL REQUIREMENTS OF THE PLANS AND SPECIFICATIONS. ANY INTENDED DEVIATION FROM THE PLANS AND SPECIFICATIONS MUST BE SPECIFICALLY IDENTIFIED BY THE CONTRACTOR AND SPECIFICALLY APPROVED BY THE ENGINEER TO BE ACCEPTABLE. WORK PERFORMED BY THE CONTRACTOR PRIOR TO RECEIVING ENGINEER'S OR OWNER'S WRITTEN APPROVAL SHALL BE AT THE CONTRACTOR'S OWN RISK. ANY SUCH WORK REQUIRED BY THE ENGINEER OR OWNER TO BE REMOVED AND/OR REPLACED SHALL BE AT THE EXPENSE OF THE CONTRACTOR.

LIST OF SUBMITTALS

1. PYŁ KTŚPAKY PROBYCY DASK Y PROPYTY WASTANA PYROTHAS X X 2. PILE REPAIR CAPACITY CALCULATIONS – PRIOR TO MATERIAL PURCHAS 3. PARA PROBYCA DASKA A WASTANA A WASTANA

- 5. SUPPORT BEAM OR SLAB INSTALLATION PLAN 14 DAYS PRIOR TO MOBILIZATION
- 6. COLD WEATHER OPERATIONS 14 DAYS PRIOR TO MOBILIZATION
- 7. WORK PLAN & SCHEDULE 14 DAYS PRIOR TO MOBILIZATION

MA**PERMITTING**

- 9. CONCRETE MIX DESIGN PRIOR TO MATERIAL PURCHASE
- 10. CONCRETE REINFORCING SHOP DRAWINGS PRIOR TO MATERIAL PURCHASE AND SHOP DRAWINGS
- 11. RED-LINED AS-BUILT DRAWINGS WITHIN 30 DAYS OF FINAL COMPLETION

AS-BUILT PLANS


THE CONTRACTOR SHALL MAINTAIN A SET OF AS-BUILT PLANS IN THE ONSITE PROJECT OFFICE. THE AS-BUILT PLANS SHALL BE KEPT UP TO DATE THROUGHOUT THE PROJECT WITH THE LATEST AS-BUILT DIMENSIONS AND DETAILS AS APPROVED BY THE ENGINEER AND SHALL BE SUBMITTED TO THE OWNER AT THE END OF THE PROJECT. FINAL PROJECT PAYMENT SHALL NOT BE MADE TO THE CONTRACTOR UNTIL RED-LINED AS-BUILT DRAWINGS HAVE BEEN SUBMITTED BY THE CONTRACTOR AND APPROVED BY THE OWNER/ENGINEER.

ABBREBIATIONS

ALT		ALTERNATE		MISC	MISCELLANEOUS	
APPR	ROX	APPROXIMATE		MLLW	MEAN LOWER LOV	WATE
Q.		CENTERLINE		NA, N/A	NOT APPLICABLE	
CLR		CLEAR		NTS	NOT TO SCALE	
CONC	2	CONCRETE		OC	ON-CENTER	
Ø,	DIA	DIAMETER		OD	OUTSIDE DIAMETER	R
DEMO)	DEMOLISH		PL	PLATE	
DIM		DIMENSION		REINF	REINFORCE, REINF	ORCING
DWGS	5	DRAWINGS		REQ'D	REQUIRED	
ELEV,	, EL	ELEVATION	2	SIM	SIMILAR	
FT		FOOT, FEET	.=	STD	STANDARD	
GA		GAUGE	*	SYMM	SYMMETRICAL	
GALV		GALVANIZED		THRU	THROUGH	
IN		INCH, INCHES		TYP	TYPICAL	Ŕ
LF		LINEAR FEET		W/	WITH	
MAX		MAXIMUM		·		




ISSUED FOR BID MARCH 5, 2025

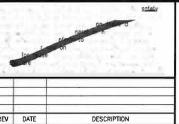


ALASKA RAILROAD SEWARD
PASSENGER DOCK WEST REPAIR

GENERAL NOTES


DESIGNED BY: EAG DATE: 3/5/25
CHECKED BY: DS PROJECT NO:

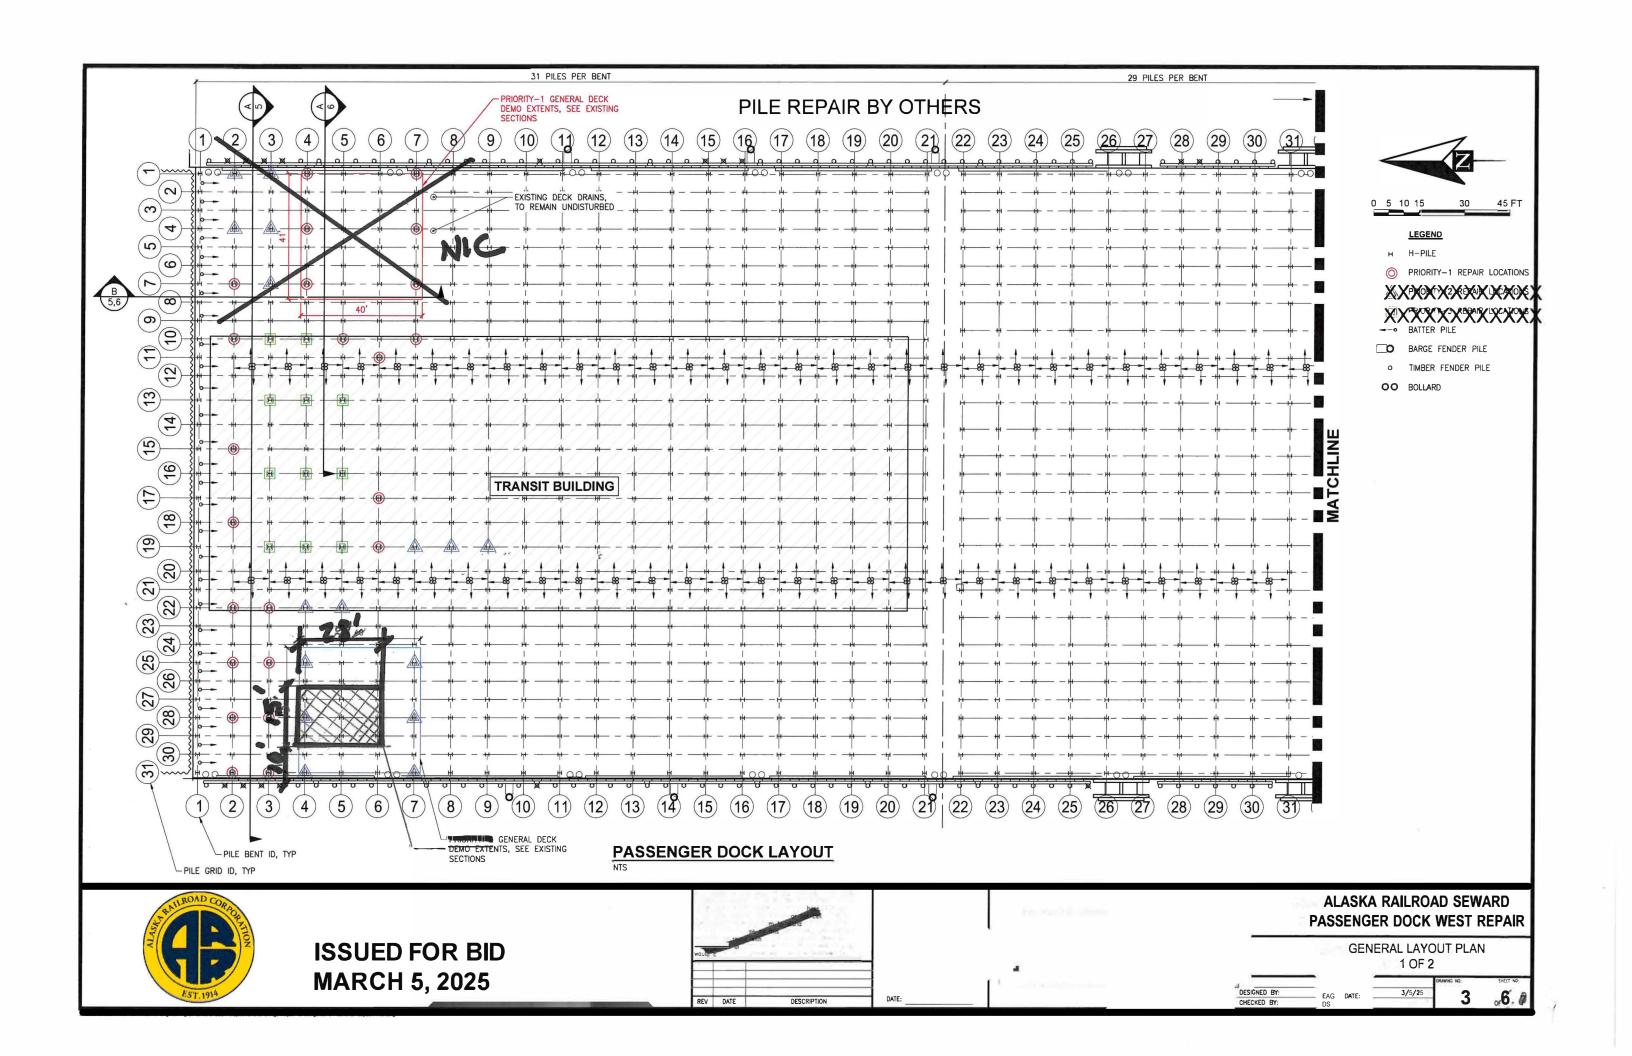

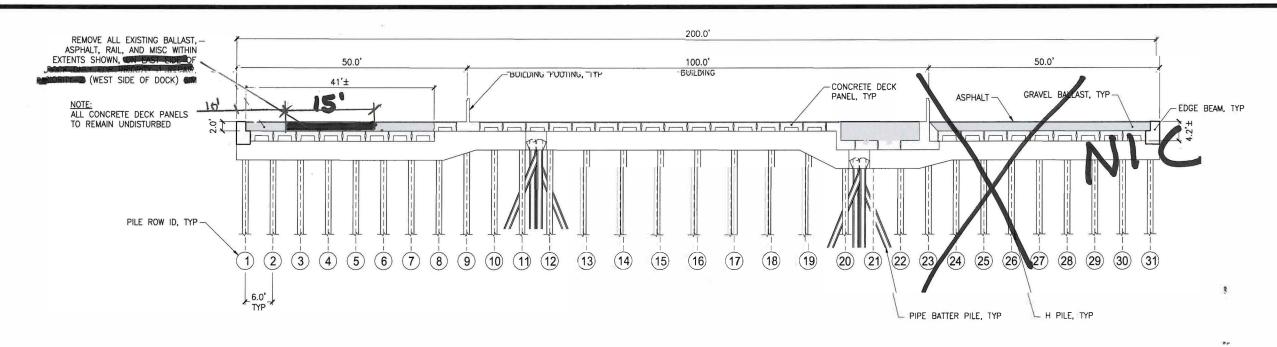

BENT SECTION - EXISTING AND DEMO 5 NTS


PILE REPAIRS BY OTHERS

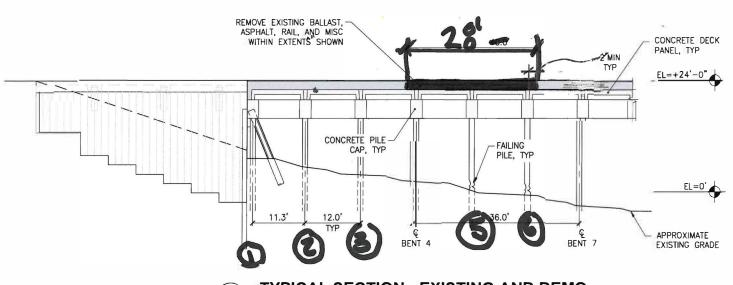

B TYPICAL SECTION - EXISTING AND DEMO
5 NTS



ISSUED FOR BID MARCH 5, 2025

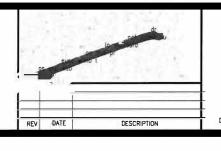


ALASKA RAILROAD SEWARD
PASSENGER DOCK WEST REPAIR


EXISTING SECTIONS

DESIGNED BY: EAG DATE: 3/5/25

CHECKED BY: DS

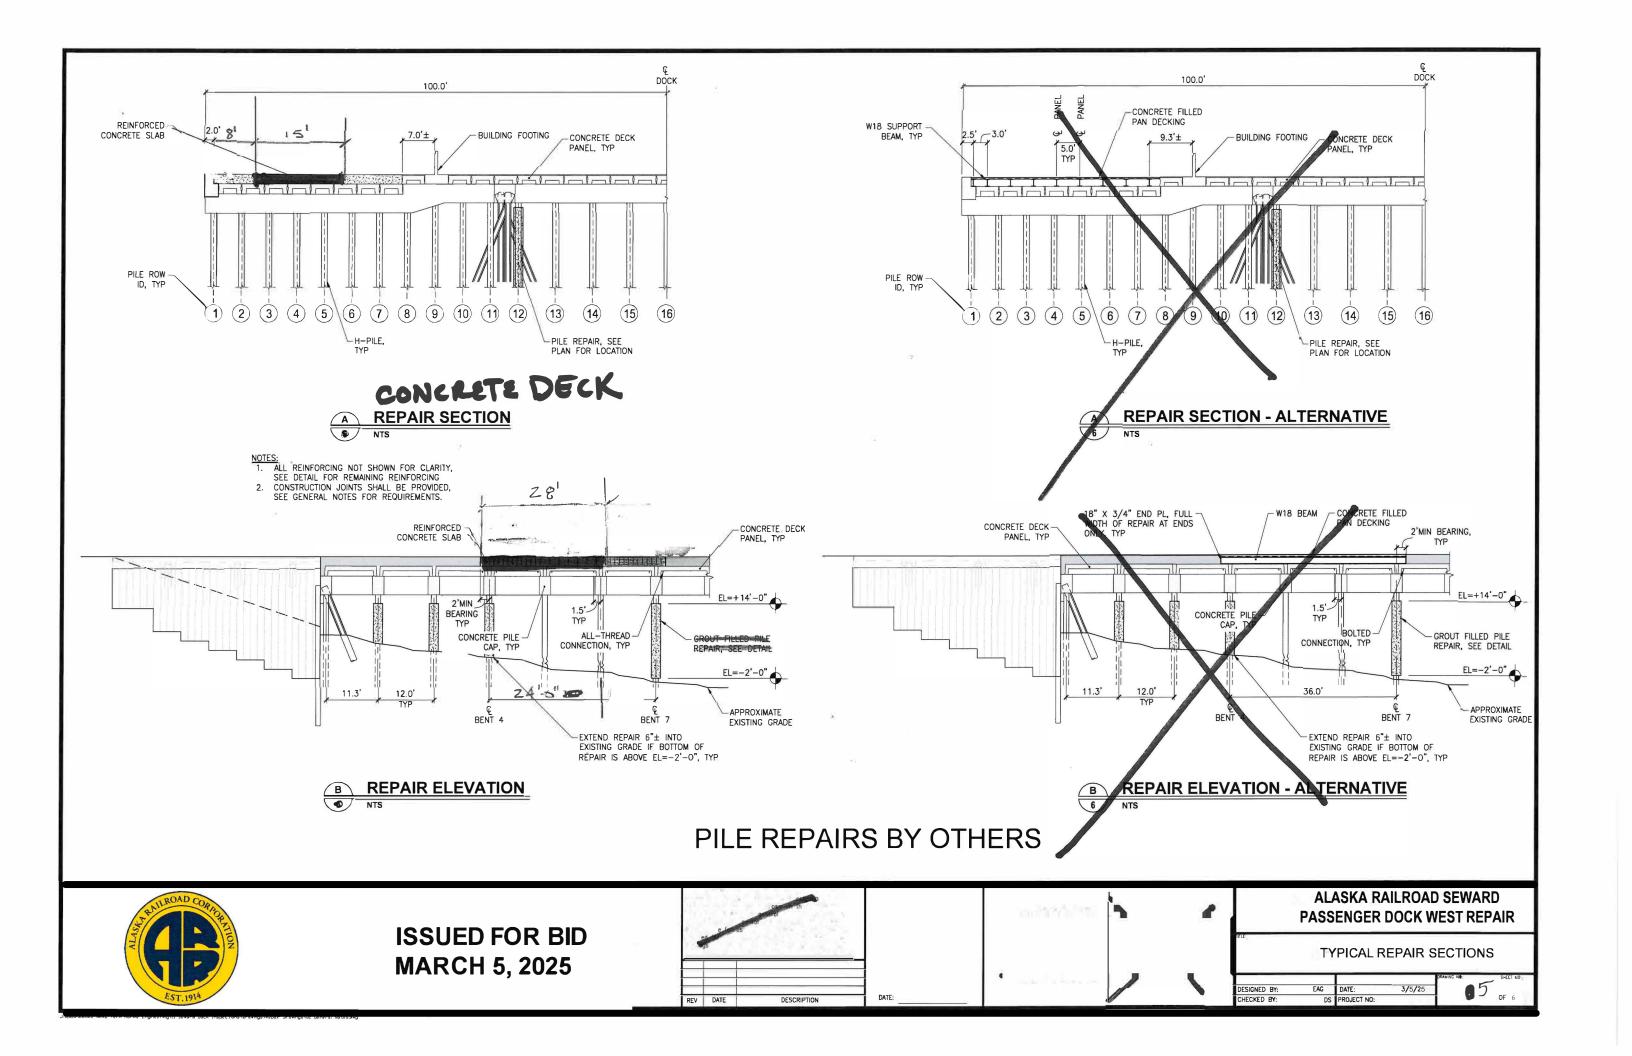


REINF

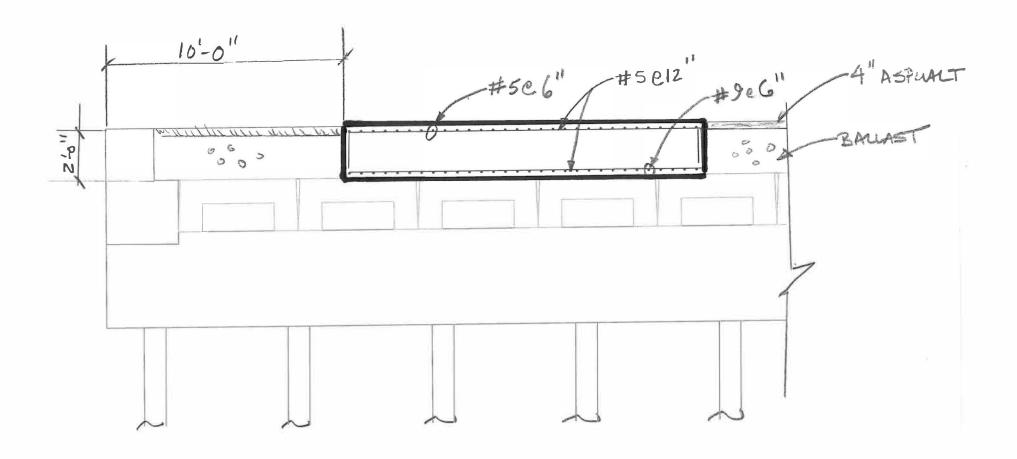

DECK SECTION NTS



ISSUED FOR BID MARCH 5, 2025

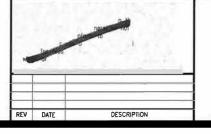

X

ALASKA RAILROAD SEWARD PASSENGER DOCK WEST REPAIR

REPAIR DETAILS

DESIGNED BY: EAG DATE: 3/3/25

CHECKED BY: DS 6 OF 6